




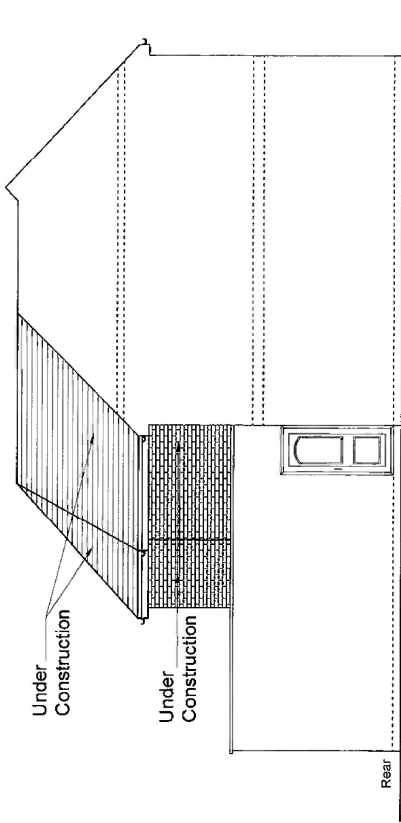


AS BUILT (without Front extension)
SIDE ELEVATION-B

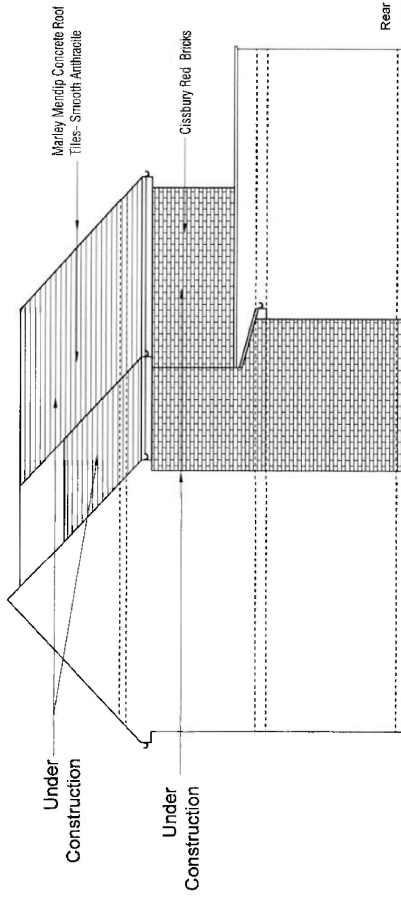

AS BUILT (without Front extension)
SIDE ELEVATION-A

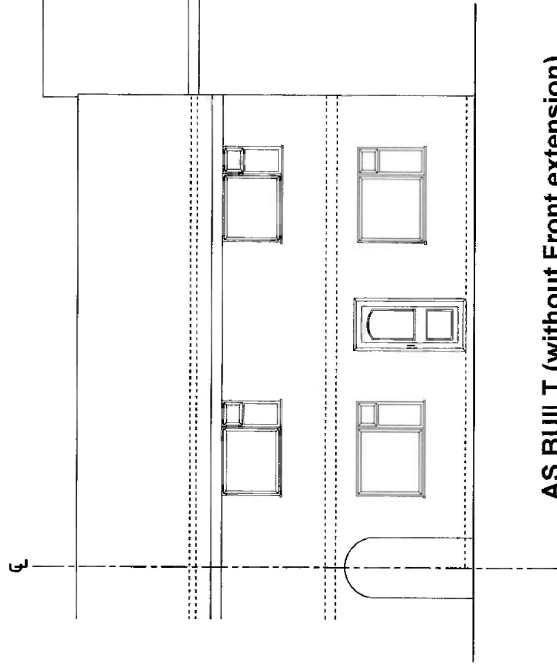

AS BUILT (without Front extension)
FRONT ELEVATION

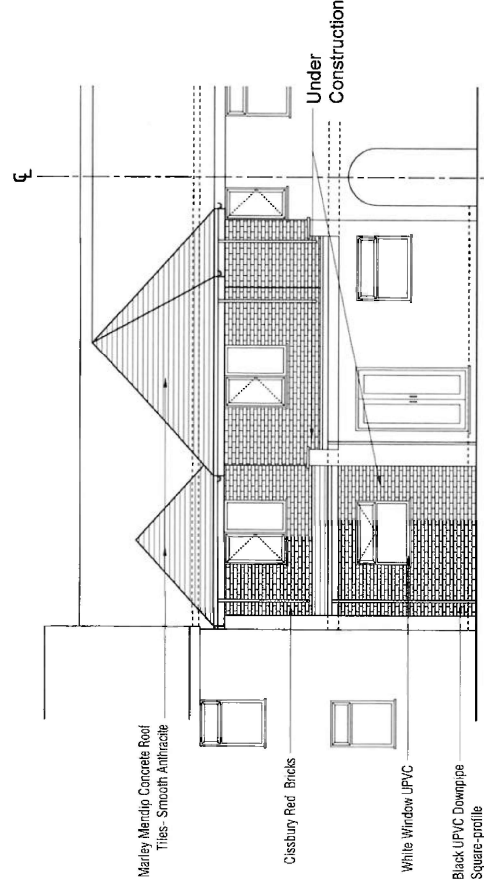

AS BUILT (without Front extension)
REAR ELEVATION

Rev B: Material info provided .
(19/08/25)- SB
Rev A: Front extension removed &
annotations changed. (21/07/25)- SB

1:5 = 25cm	1:200 = 10m
1:10 = 50cm	1:250 = 12.5m
1:20 = 100cm	1:500 = 25m
1:50 = 2.5m	1:1250 = 62.5m
1:100 = 5m	1:2500 = 125m

Copyright Z.S. Partnership Ltd.(20 24)

PLANNING ISSUE

ZSP
ZS Partnership Ltd.
Architectural Design & Planning
469 Coventry Road, Small Heath
Birmingham B10 0TJ
0121 772 4096

Drawing Title	
Proposed Front and Side Elevations	
Proposal:	
Retention of Single Storey/Part Two Storey Rear Extensions	
Project Location:	
7 Limes Avenue, Rowley Regis West Midlands B65 8AZ	
Scale:	1/100 @ A3
Drawn:	Ash/RA
Drawing No:	19/06/25
Amendments	A
Note: This drawing to be read in conjunction with dwg No ZL 563/14	