


SUMMARY OF STEEL BEAMS:

- ~~B2: 2x4 20x10x19 UB~~
- ~~B3: 2x4 20x12x30 UB~~
- B4: 2x4 20x13x30 UB
- B5: 2x4 20x13x30 UB
- B6: 1x4 20x10x19 UB
- B7: 1x4 25x4x25x73 UC

KEY:

- # HEAT DETECTOR
- SMOKE DETECTION ALARM
- * HALF HOUR FIRE DOOR WITH SC

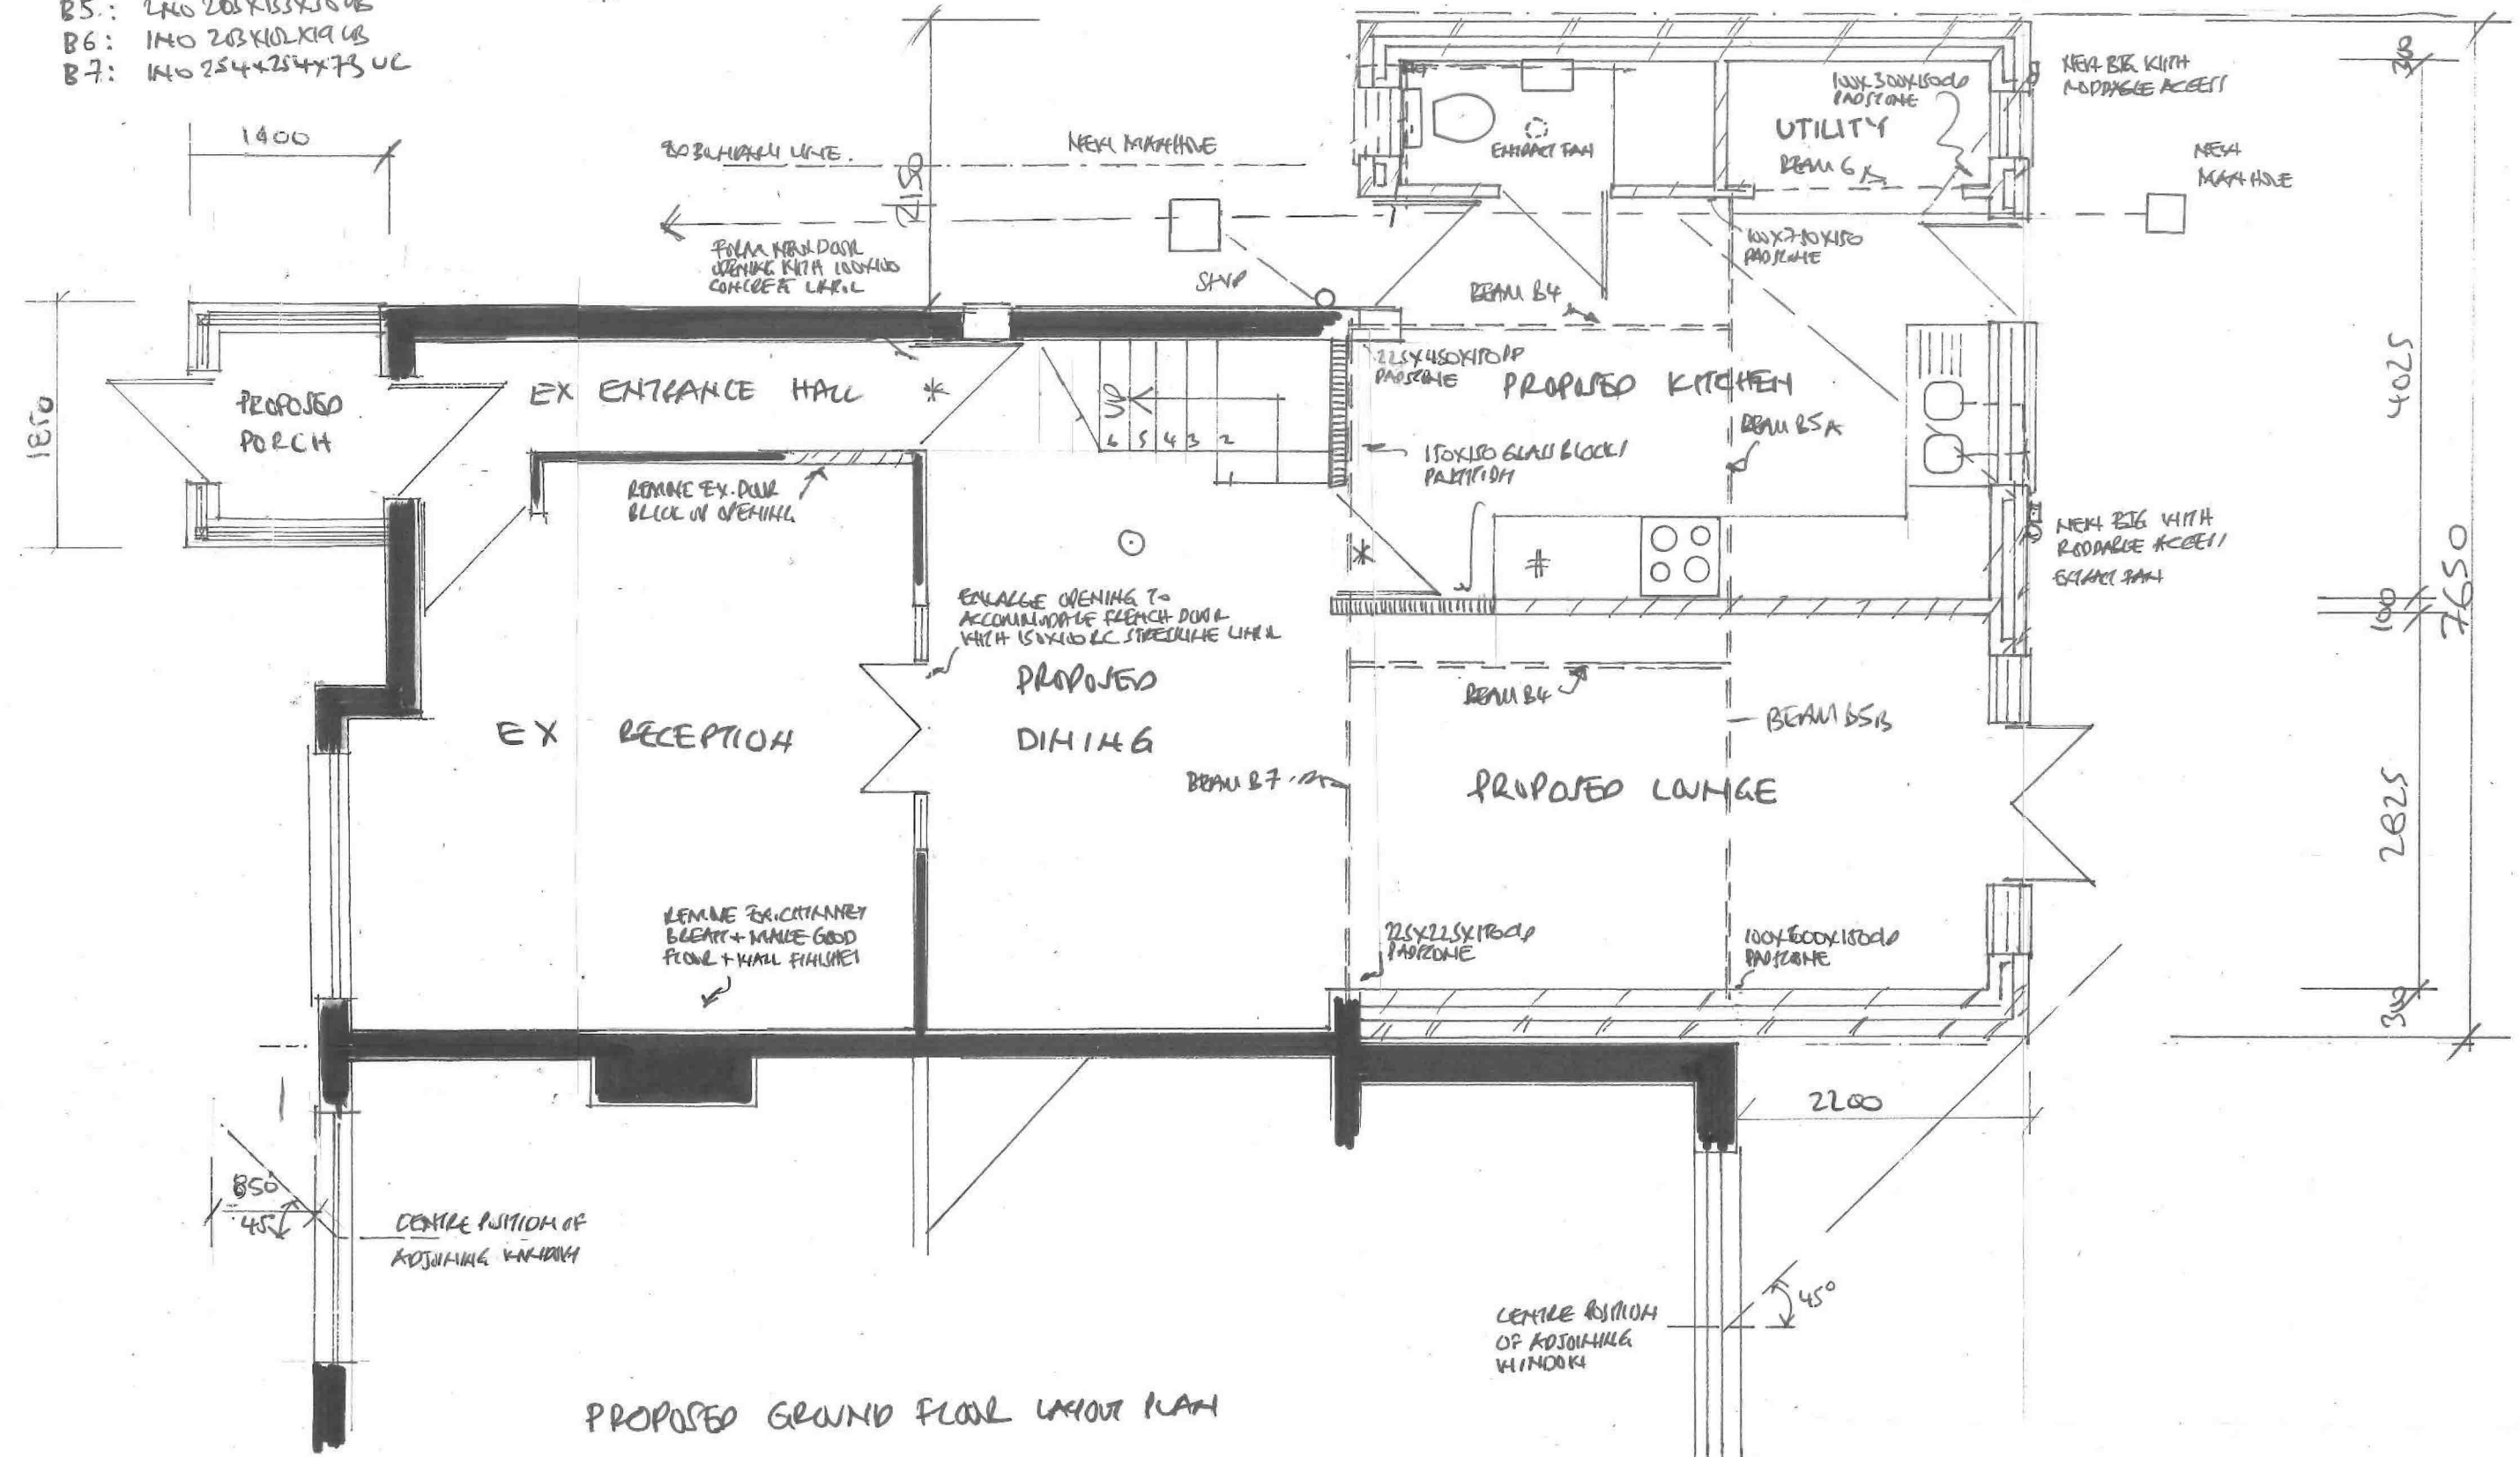

PROPOSED GROUND FLOOR LAYOUT PLAN

AMENDMENT

1. EXTENDED RECEPTION DELETED
2. PORCH REPOSITIONED.

Proposed Ground Floor Plan	4/A
June 2025	Scale: 1:50